


BET	ANT	ÄNDRINGEN AVSER	DATUM	SIGN
RELATIONSHANDLING				
SÄRSTA 3:43 KNIVSTA				
BH	Miab Förvaltning AB	018-65 67 85	018-65 67 88	
A	Kilgren Arkitektkontor AB	018-10 44 30	018-69 58 11	
K	Bjerking AB	018-65 11 00	018-71 04 85	
VS	Vkab	018-10 04 80	018-10 04 11	
V	AC installation AB / LLT	018-29 23 20	018-29 23 22	
E	Bjerking	018- 65 11 00	018-14 56 05	
UPPROGNR	7084	RITAD/KONSTR AV	LK	HANDLÖSARE
DATUM	2006-01-27	ANSVARIG	GK	Kilgren
Apoteksvägen 8				
Plan 03				
SKALA	A1=1:100	NUMMER	A-40.1-0003000	BET
	A3=1:200			

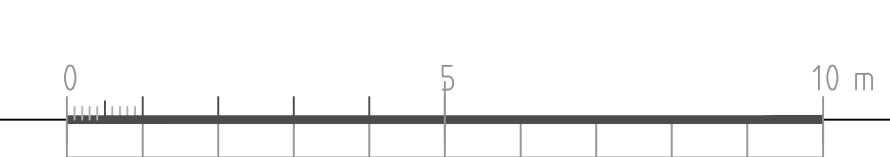

RText (RText)

LAGER: SB11

PLO: 2014-03-24 13:03 Z:\FÖRVALTNING\FÄSTIGHE TER\8030_SÄRSTA 3_43_APOTEKSVÄGEN 8\BÄTTNINGAR\DWG\A-40_1-0103000.DWG ERIK JÄGARE